

LOWBURNVILE DEVELOPMENTS LTD
SUBDIVISION ENGINEERING ASBUILT

C. HUGHES & ASSOCIATES

CONSULTANTS IN:

SURVEYING AND LAND DEVELOPMENT
RURAL AND URBAN PLANNING
RESOURCE MANAGEMENT
CROMWELL AND WANAKA

SCALE
1:500

JOB No.
3668

DATE
MARCH 98

PLAN No.
C 506

AVAILABLE FROM A
LEADING OFFICE
EQUIPMENT DEALER

DRAWING No. Town Centre - Murray Terr.

SERVICES RECORD

15/4/19/11/1

15/4/19/11/1

15/4/19/11/1


15/4/19/11/1

15/4/19/11/1

15/4/19/11/1

15/4/19/11/1

666 500 m N
666 450 m N
666 400 m N
666 350 m N
666 300 m N
666 250 m N
278 400 m E
278 450 m E
278 500 m E
278 550 m E
278 600 m E
278 650 m E
278 700 m E
278 750 m E
278 800 m E

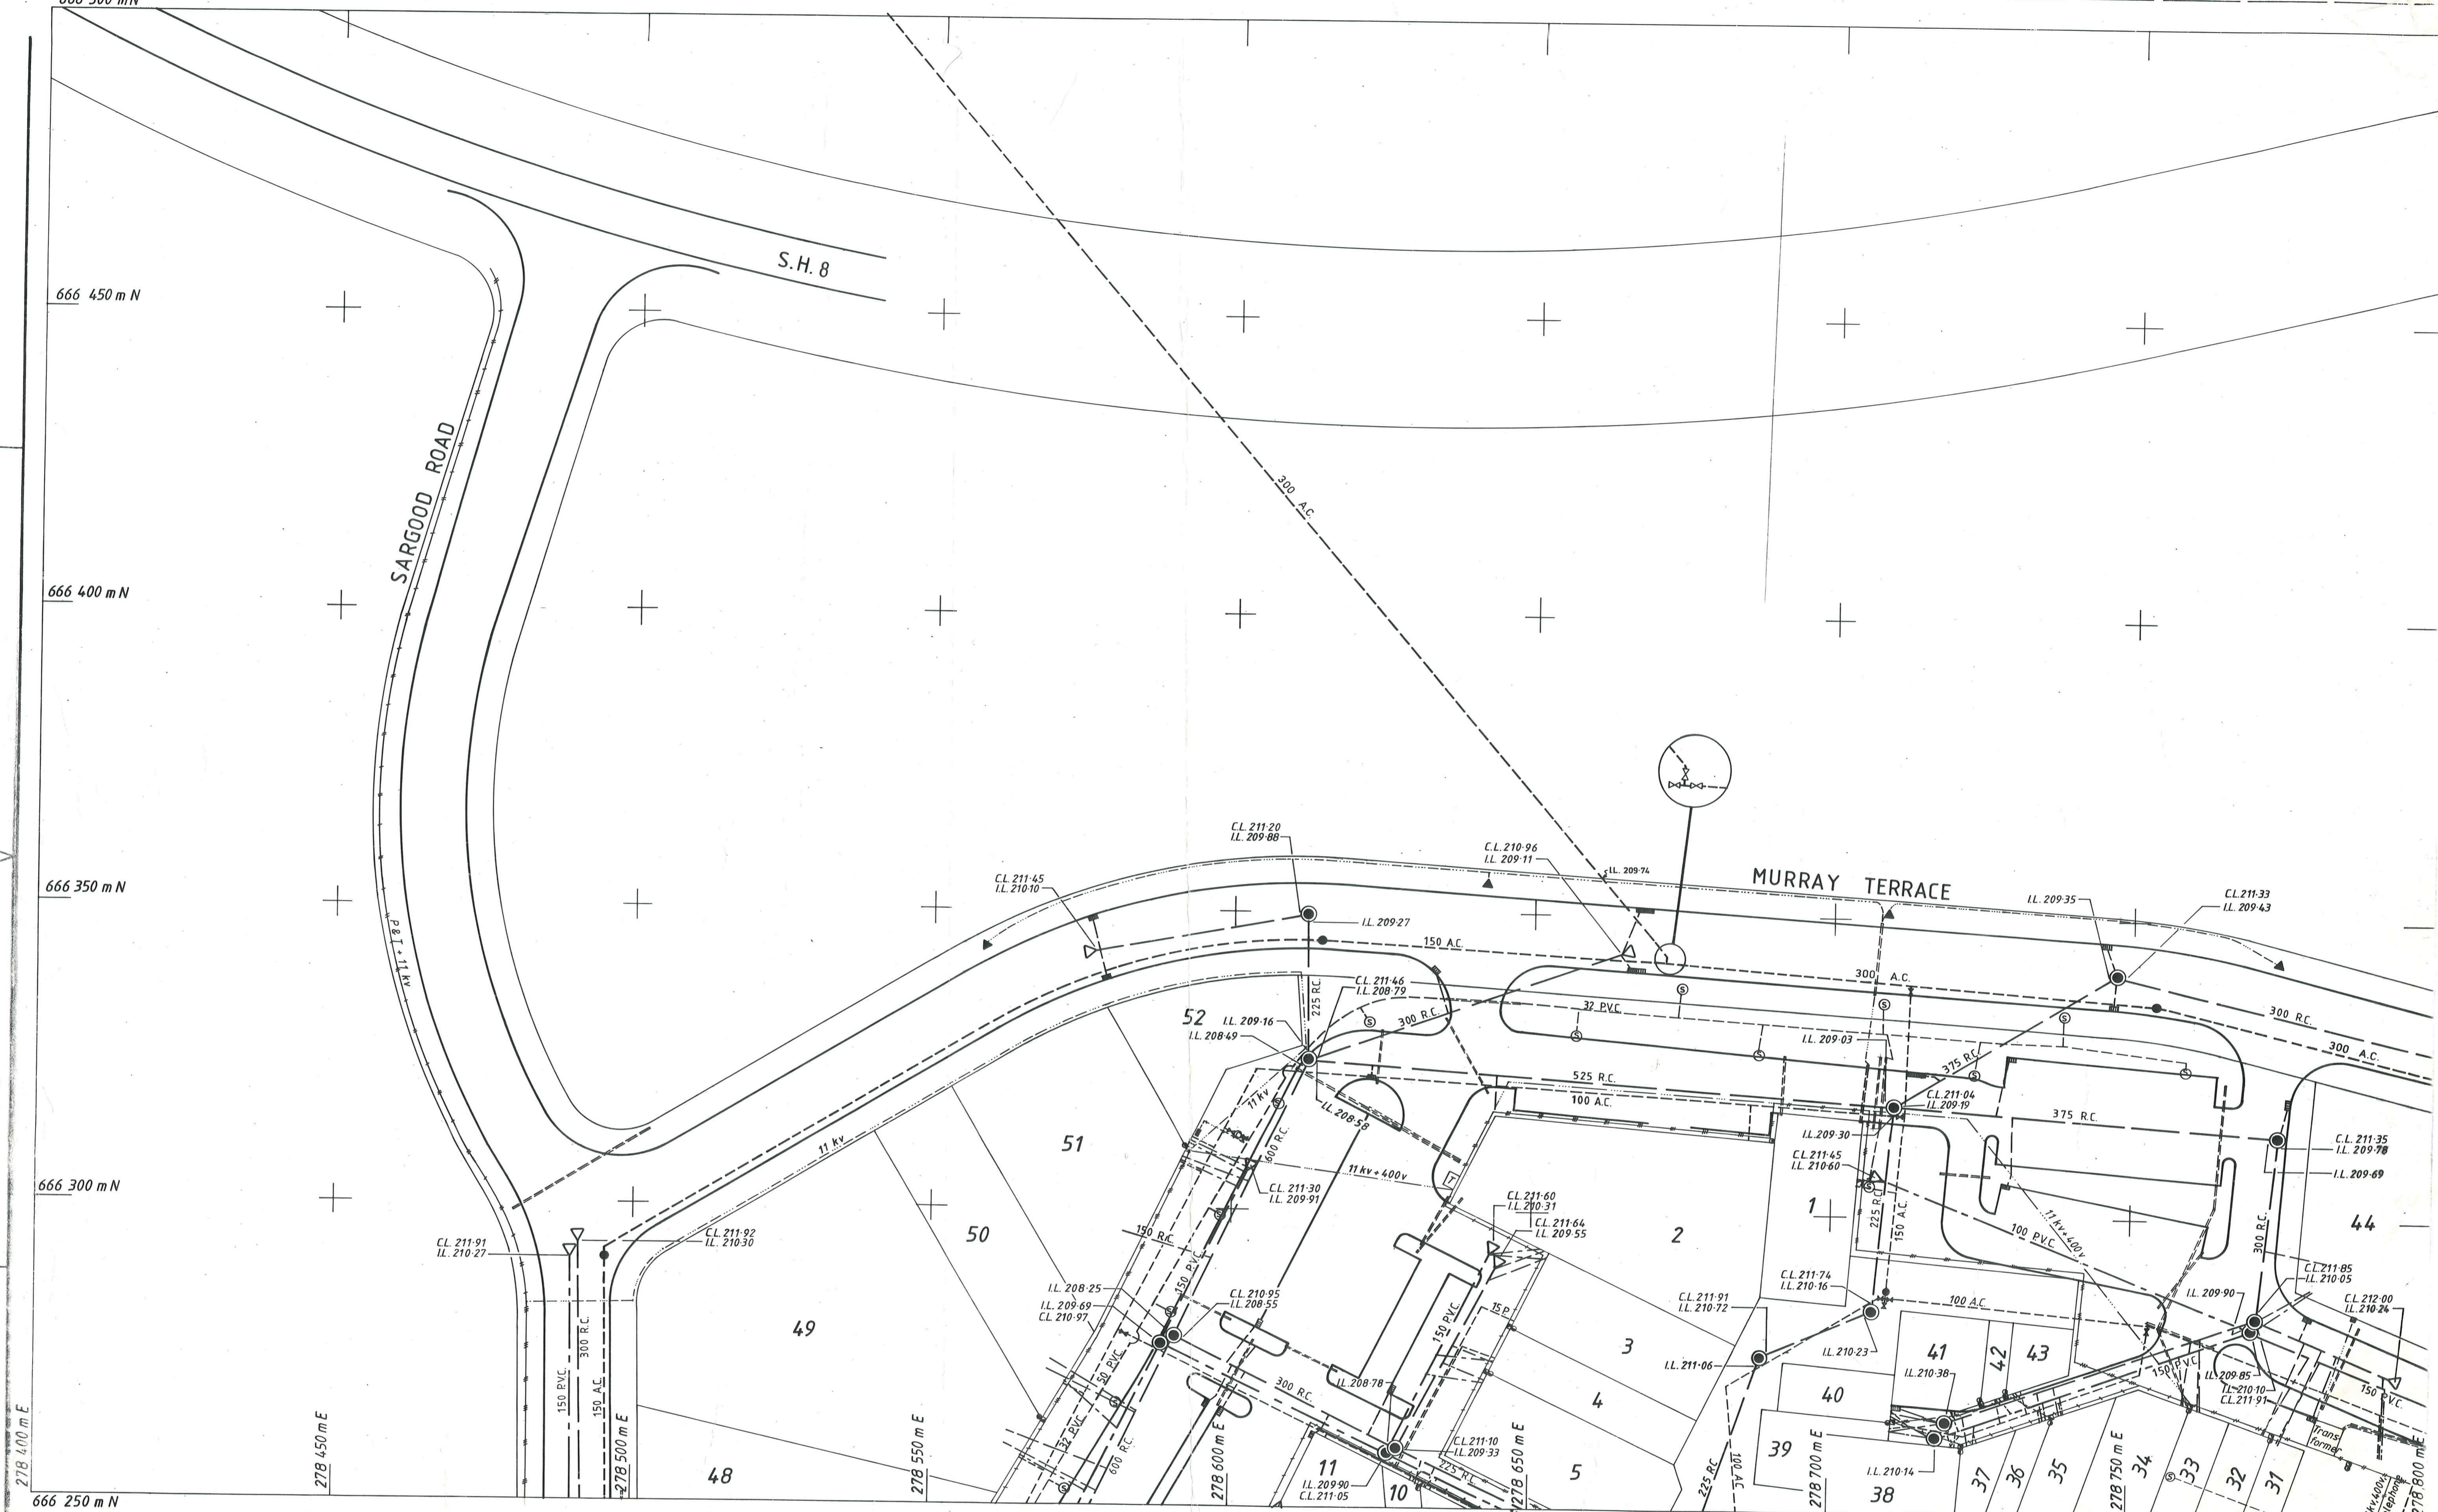

GRID REF 15/4/19/11/1

BY	CHECKED	DATE	RECOMMENDED
BY		3.85	
APPROVED			
E. Hughes Project Engineer			

Ministry of Works and Development

POWER
M. J. WILLIAMS
CHIEF POWER ENGINEER

R.G. Norman
Commissioner

**CLUTHA VALLEY DEVELOPMENT
CROMWELL EXPANSION
AREA 19-11 "AS BUILT" SERVICES**

ORIGINAL SCALES	1:500	FILE	19-11
JOB	CODE	SHEET	REVISION



Whole numbers = mm
Decimised expressions = m
unless indicated otherwise