


As Built
Waenga Drive, Wishart Crescent, Linrosa Place, Gair Ave

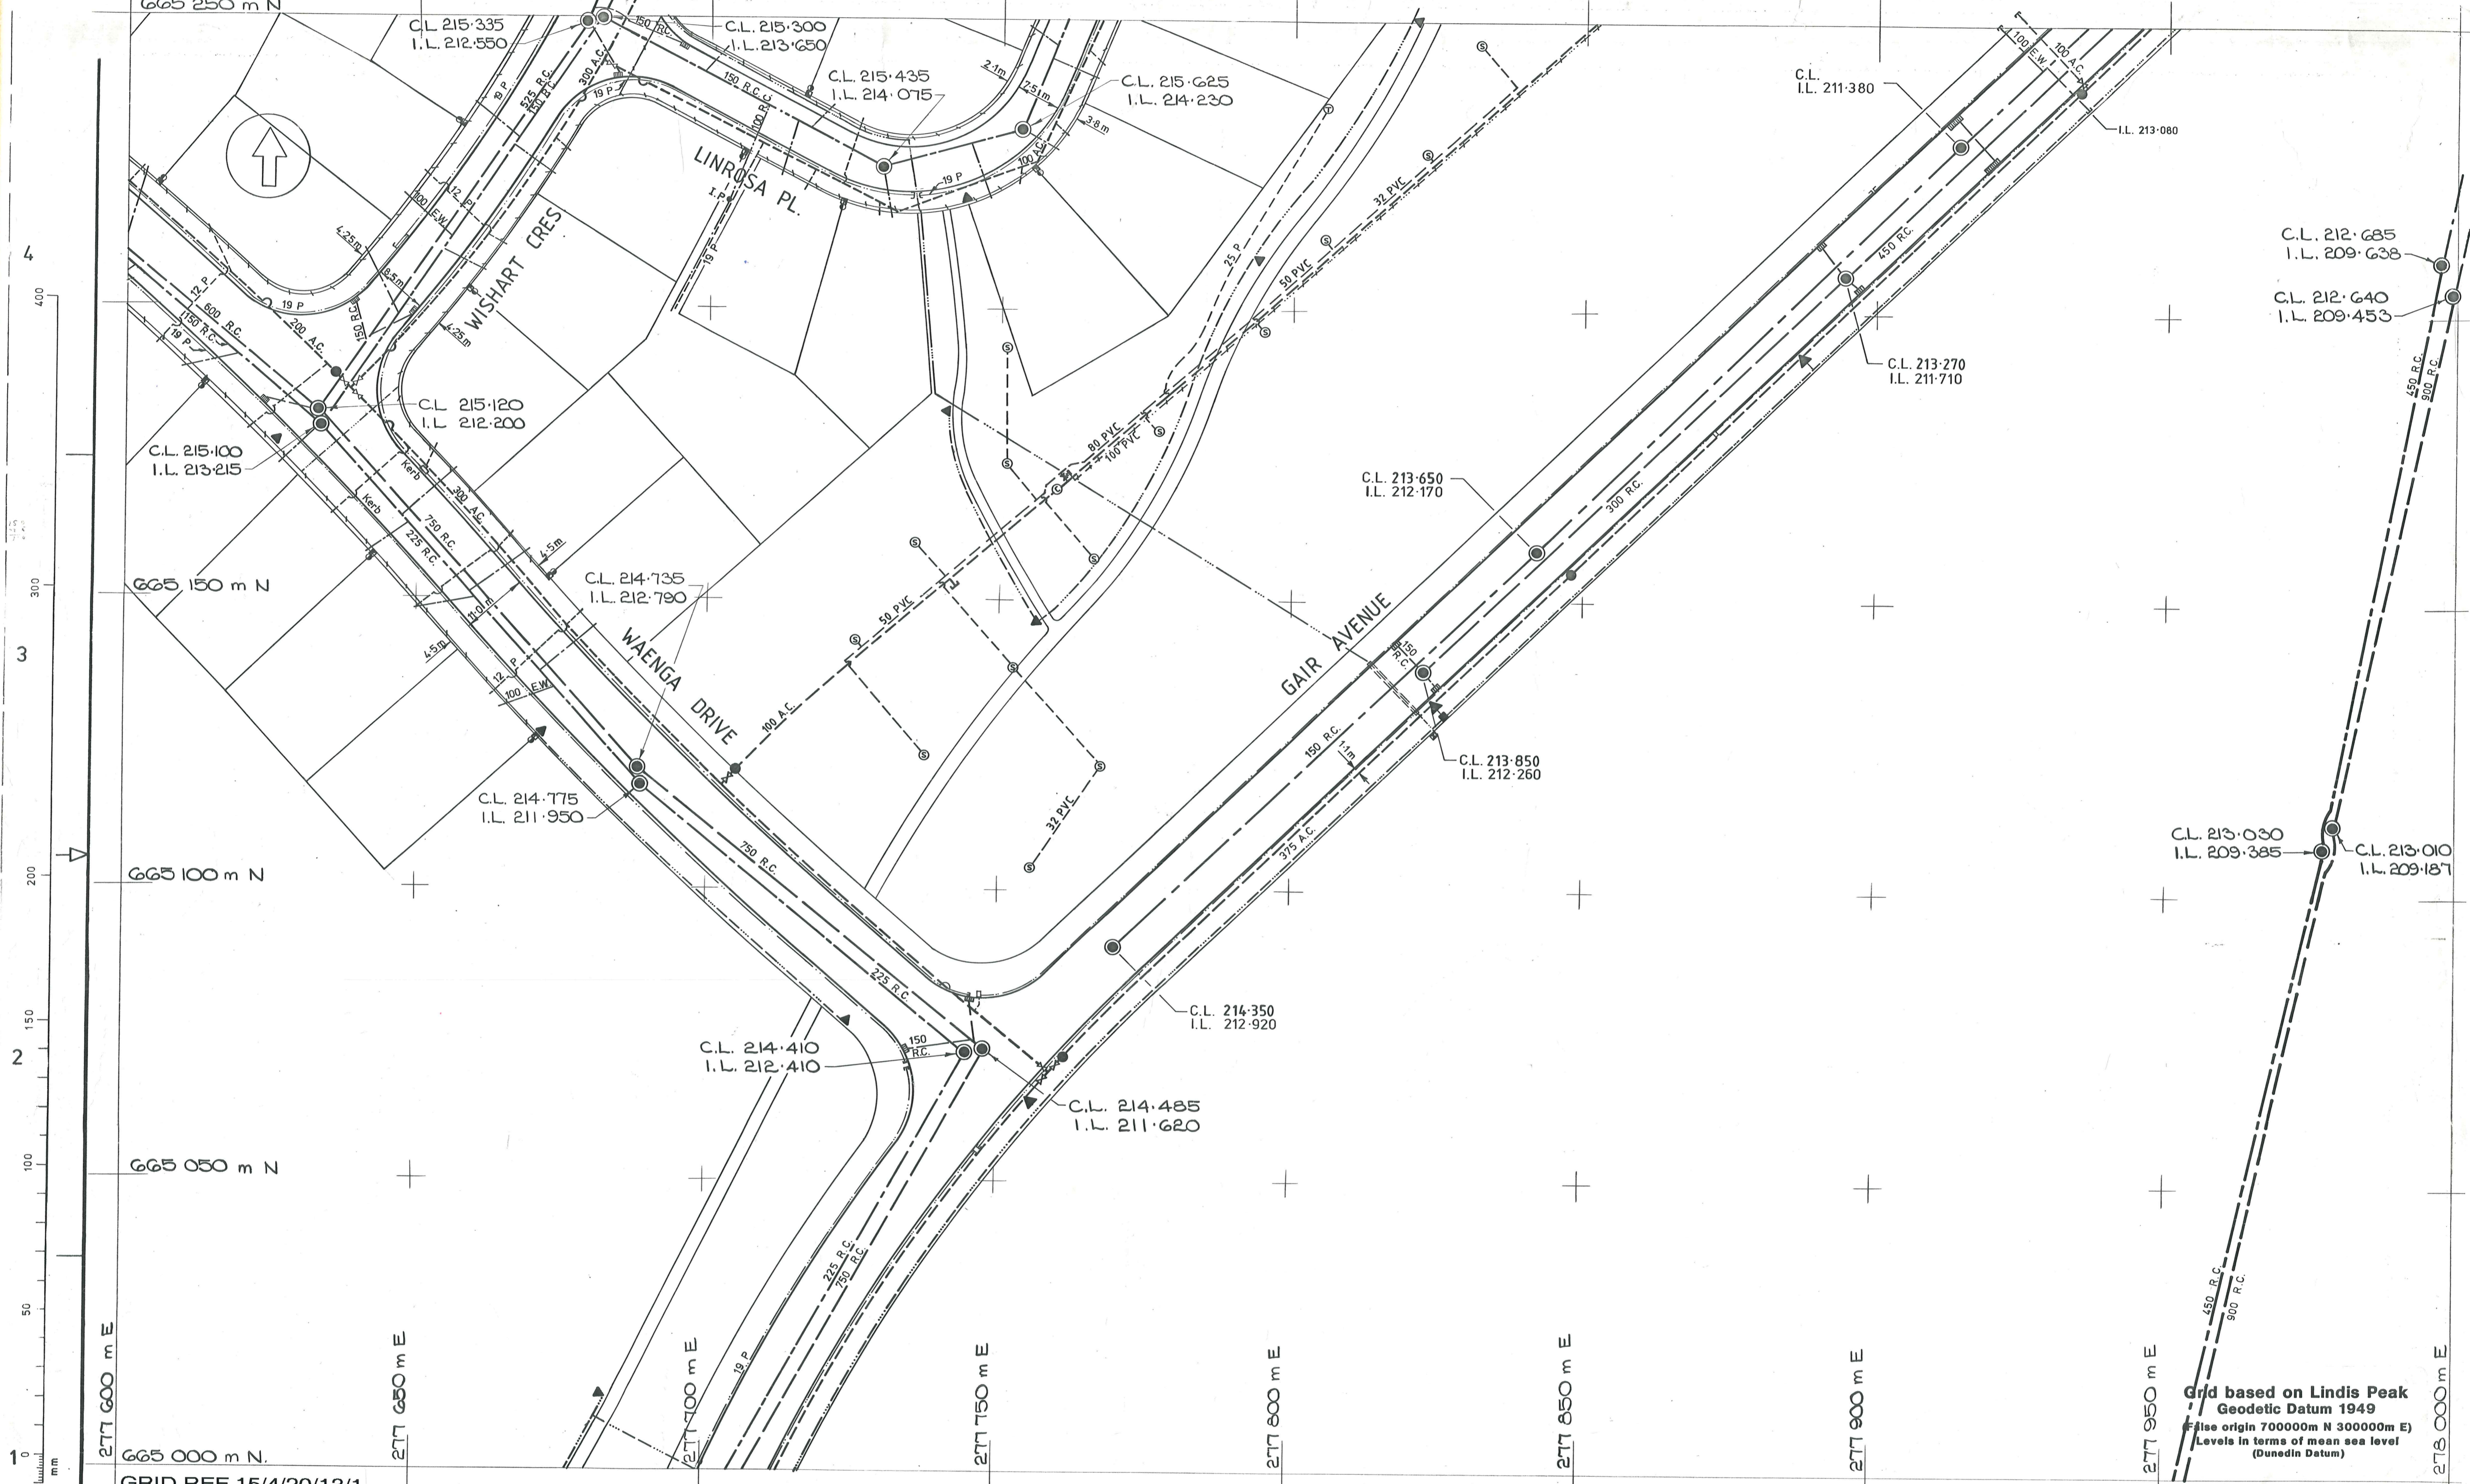

Grid based on Lindis Peak
Geodetic Datum 1949
False origin 700000m N 300000m E
Levels in terms of mean sea level
(Dunedin Datum)

15/4/20/13/1

ORIGINAL SIZE A1	DRAWN		BY	CHECKED	DATE	RECOMMENDED	 Ministry of Works and Development POWER H. W. ROBERTSON CHIEF POWER ENGINEER N.C. McLEOD Commissioner	CLUTHA VALLEY DEVELOPMENT		ORIGINAL SCALES	1:500	FILE	
	COMPILED					APPROVED		CROMWELL EXPANSION		JOB	CODE	SHEET	REVISION
	SUPERVISED					FOR T. STORY PROJECT ENGINEER		AREA 20-13: "AS BUILT" SERVICES					
AMENDMENTS		BY	APPD.	DATE									
LOCAL OR TRACING No.		1:1	1:2					1:500		Whole numbers = mm Decimal expressions = m			