

AVAILABLE FROM ALL
LEADING OFFICE
EQUIPMENT DEALERS

As Built


Cromwell College, Barry Avenue

15/4/20/7/2


TO RE-ORDER QUOTE
NUMBER 0510

DRAWING NO.

DETAILS

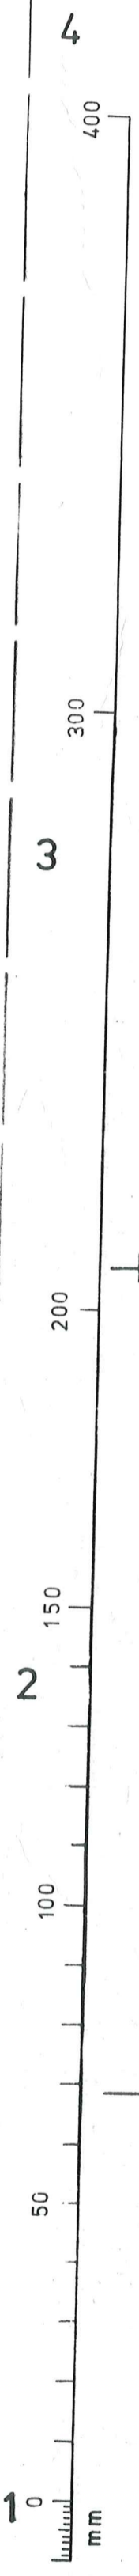

ORIGINAL SIZE
A 1

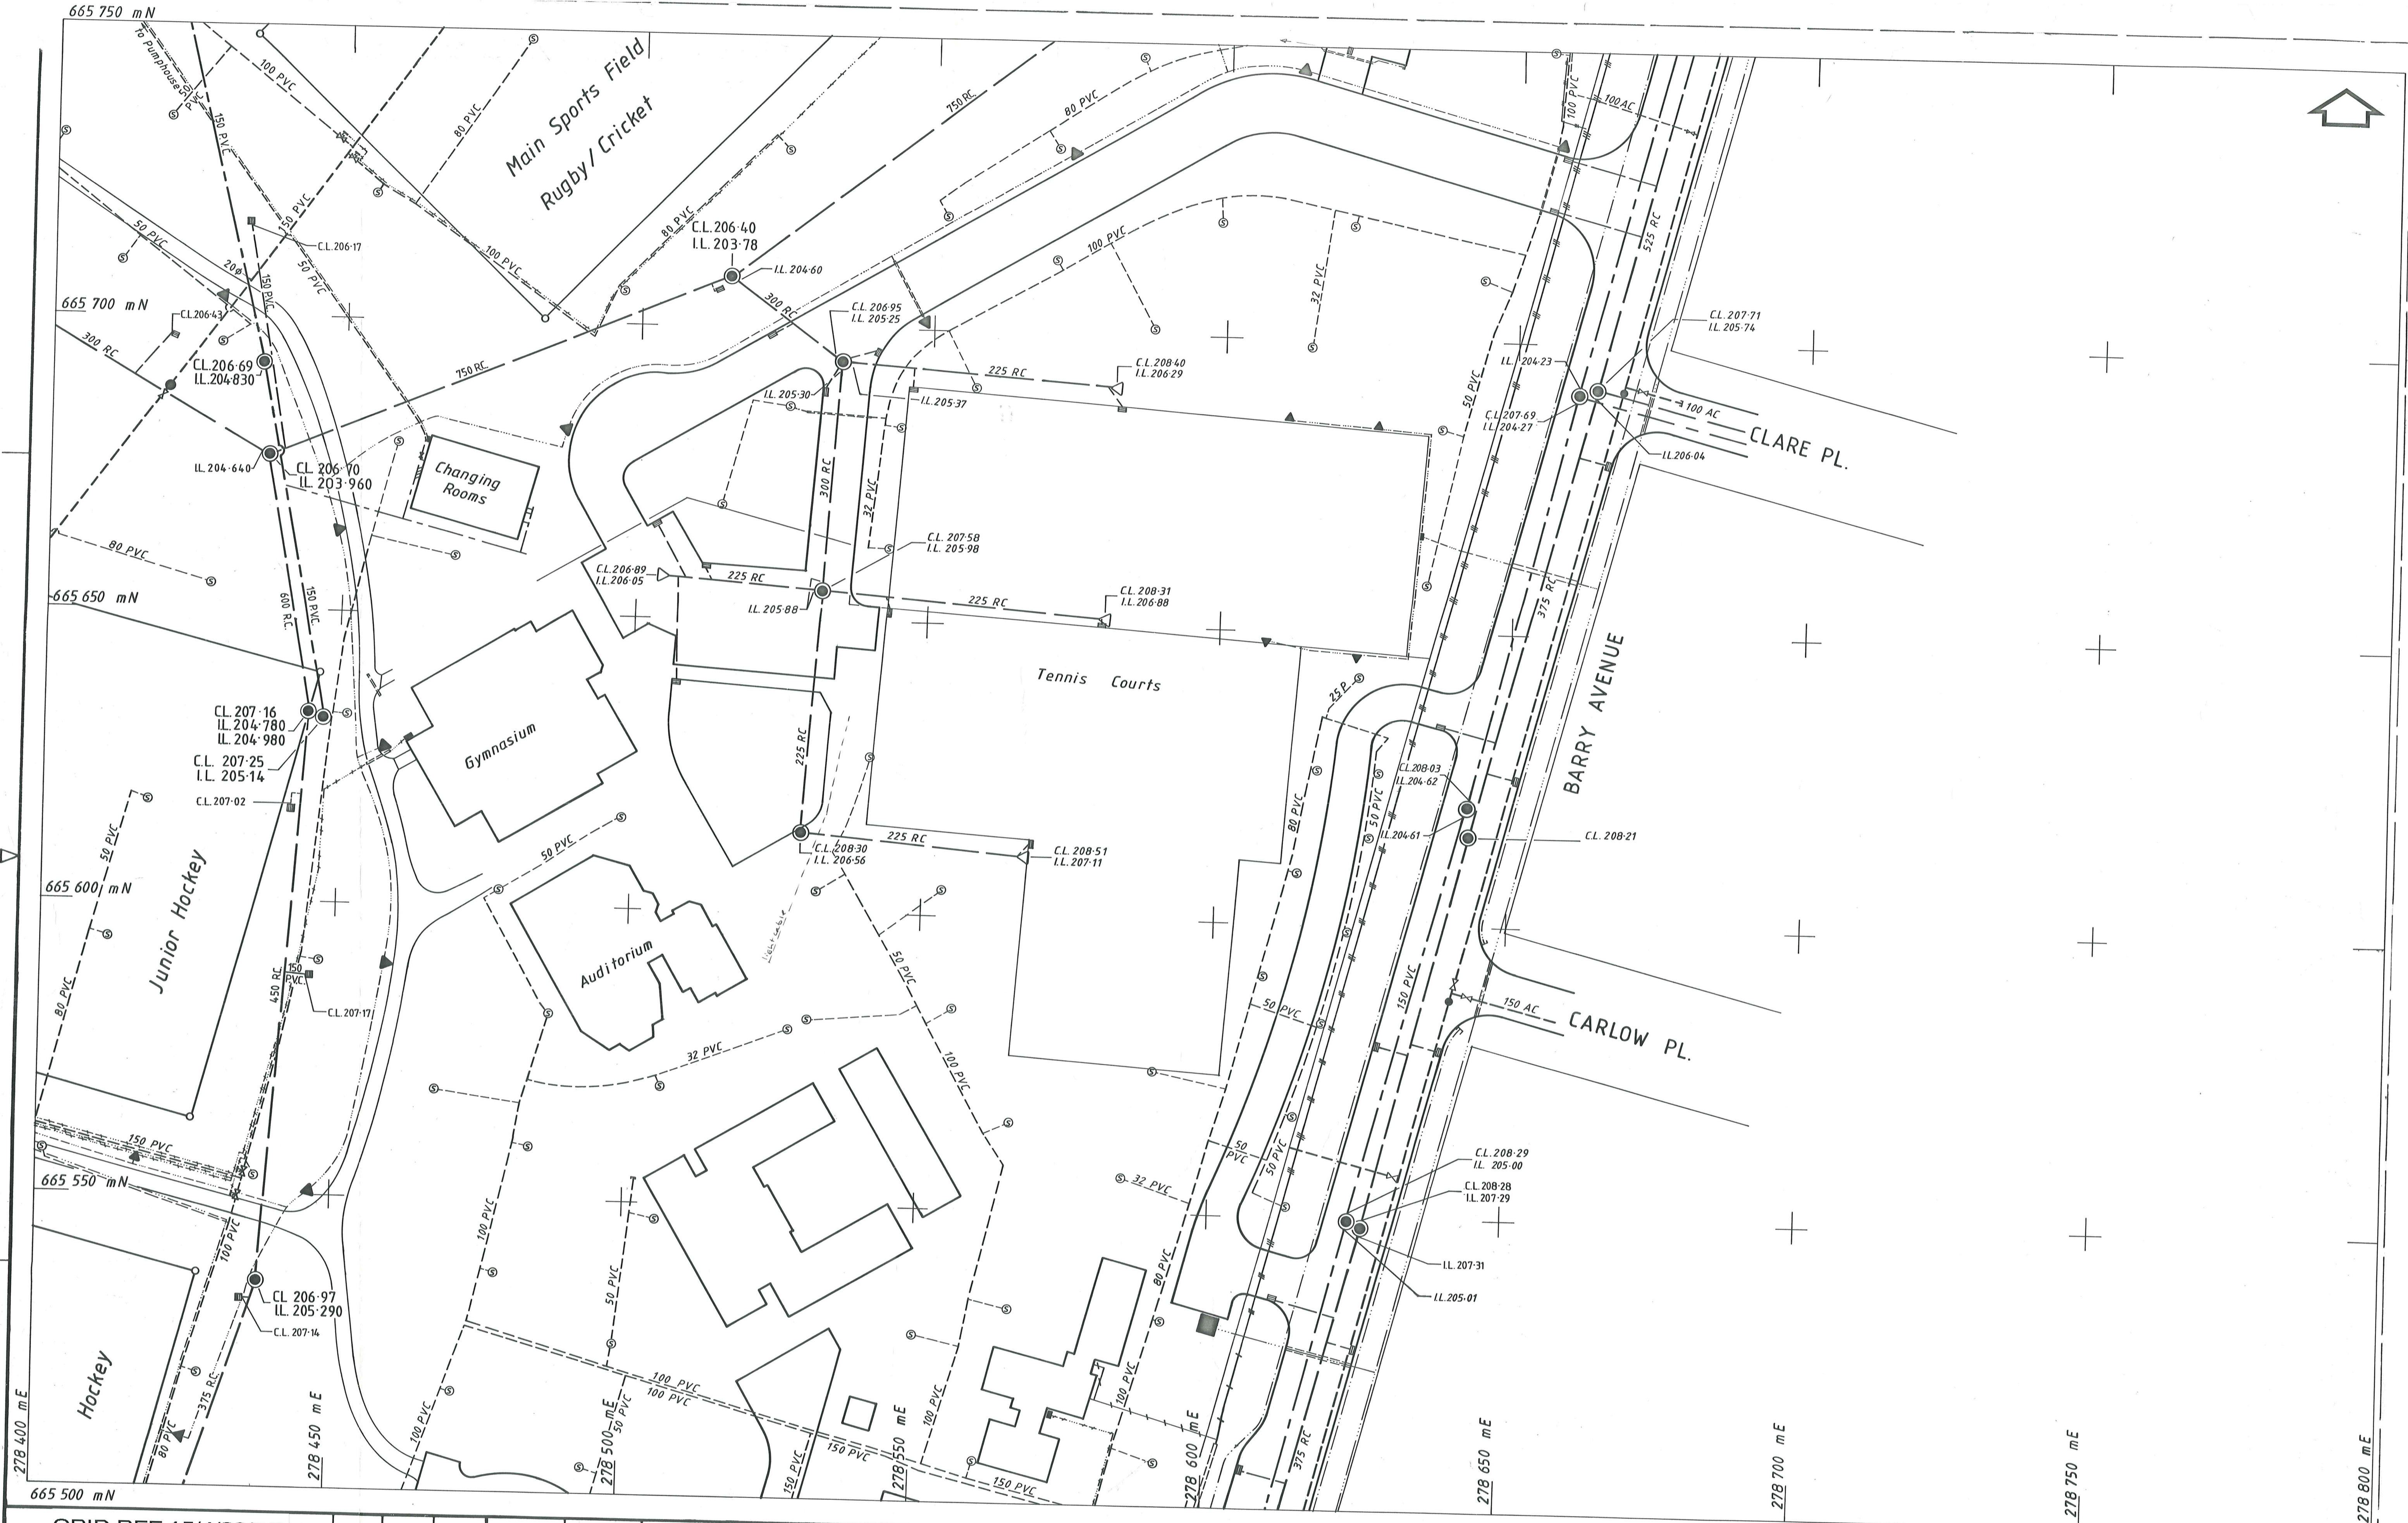

GRID REF 15/4/20/7/2

DRAWN	BY	CHECKED	DATE	RECOMMENDED
	G.B.		21.9.84	
			15.9.86	
APPROVED				
E Hughes Project Engineer				

Ministry of Works and Development


POWER
M. J. WILLIAMS
CHIEF POWER ENGINEER

R.G. Norman
Commissioner



CLUTHA VALLEY DEVELOPMENT
CROMWELL EXPANSION
AREA 20-7 "AS BUILT" SERVICES

ORIGINAL SCALES	1:500	FILE
JOB	CODE	SHEET
		REVISION

W. 482-A1 LOCAL OR TRACING No.

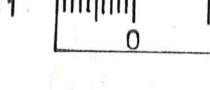

1:2

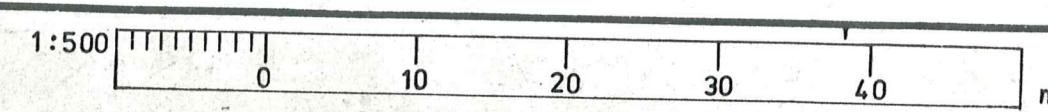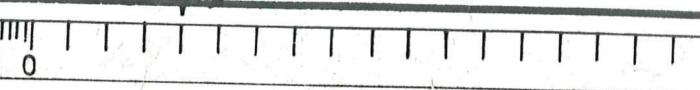

Whole numbers = mm
Decimal numbers = mm