

665 750 m N

665 700 m N

665 650 m N

665 600 m N

665 550 m N

665 500 m N

278 650 m E

278 900 m E

278 950 m E

279 000 m E

279 050 m E

279 100 m E

279 150 m E

279 200 m E


26.4.90
K. Third has orig
for updating

NOTE -
ELEC CABLE in SAME
TRENCH from CONTROL
BOX @ of COLERAINE ST
to SV 11.6

WICKLOW ST.

DOWN STREET
GREENWAY


COLERAINE ST.

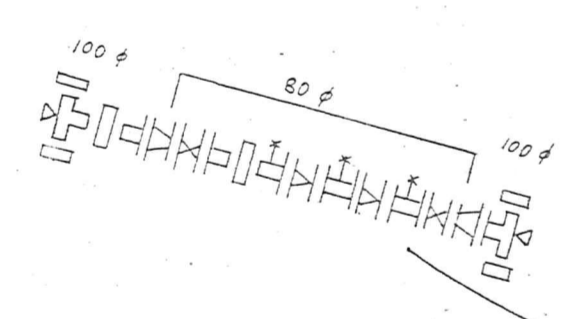

SOLINOID VALVE
No. 8

CABLE ONLY

100 ft AC Drain

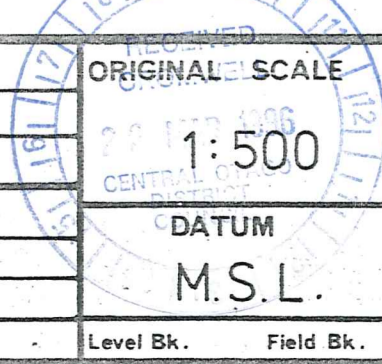

JOHNSTON HATFIELD HUGHES & PARTNERS
Planning & Surveying Consultants Phone CMW 50-376
Registered Architects, Cromwell P.O. Box 51

CROMWELL BOROUGH COUNCIL

Certified Correct
[Signature]
Registered Surveyor

ASBUILT DRAWINGS
CONTRACT 55/1/6 (Third)
11 Fairfield Asphalt

2018

SURVEY	<i>[Signature]</i>	10/82	DRAWN	
LEVEL			TRACED	
DESIGN			CHECKED	
NO.	AMENDMENTS	Initials	Date	

ORIGINAL SCALE
1:500
DATUM
M.S.L.
Level Bk. Field Bk.

JOB No. C147
PLAN No. C 72
2 of 7 Sheets