


Rubbish Dump

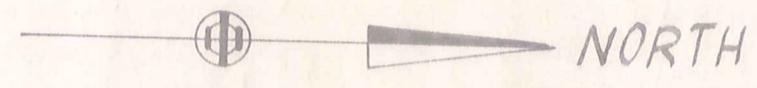

Skating Dam

CHANNEL ROAD

To Oxidation Ponds

2.00m

225 dia

6.00m

Edge of existing gravel road

boundary line

BOROUGH BOUNDARY

HOLYWOOD STREET

ALLEN STREET

DERWENT STREET

Oxidation Ponds

Skating Dam

Scale 1:1000

1.60m

exist. fence

225 dia

A8

Hogburn Channel

JOINING LINE SHEET 2

LEGEND

- (46) Property Connection Number
- 150 dia or 125 dia Main Sewer and Diameter
- Y "Y" Junction only on Main Sewer
- Property Lateral Connection (100 dia)
- A21 Manhole and Manhole Number
- A21a Lamphole and Lamphole Number

DUFFILL WATTS & KING LTD
 CONSULTING CIVIL & STRUCTURAL ENGINEERS
 11, The Arcade, P.O. Box 5000, 77-102, Haverhill, P.O. Box 676, Pl. 53049
 Haverhill, P.O. Box 280, Phone 1425

NASEBY BOROUGH
 COUNCIL

AS BUILT SERVICES - SEWERAGE

DATUM	AMENDMENTS				Appvd.	NAME	DATE	JOB NO.
	NO	BY	DATE					
Sewerage						D.C. Wilson	Feb. 78	8581
ORIGIN						B.T. Kinaston	June 78	
Assumed						B.T. Kinaston	31-6-78	1 of 5 sheets
								File 26/3/8 I.B. 374 F.B. -

NORTH

ORIGINAL SIZE INCHES

Scale 1:1000

LEGEND

- (46) Property Connection Number
- 150 dia or 225 dia Main Sewer and Diameter
- Y "Y" Junction only on Main Sewer
- Property Lateral Connection (100 dia)
- A21 Manhole and Manhole Number
- A21a Lamphole and Lamphole Number

DUFFILL WATTS & KING LTD
 CONSULTING CIVIL & STRUCTURAL ENGINEERS
 Dunedin P.O. Box 5289 Ph 77-133 Invercargill P.O. Box 576 Ph 83049
 Balclutha P.O. Box 220 Phone 1425

NASEBY BOROUGH
 COUNCIL


AS BUILT SERVICES - SEWERAGE

DATUM
 Sewerage
 ORIGIN
 Assumed

AMENDMENTS			NAME	DATE	JOB NO.	Sheet No
NO	BY	DATE			8581	2
			Surveyed	D.C. Wilson Feb. 78		
			Drawn	BT Kinaston June 78		
			Calculations			
			Traced	BT Kinaston June 78		
			Checked	BT Kinaston June 79	of 5 sheets	
			Approved		File 26/3/8	L.B. 374



ORIGINAL SIZE INCHES

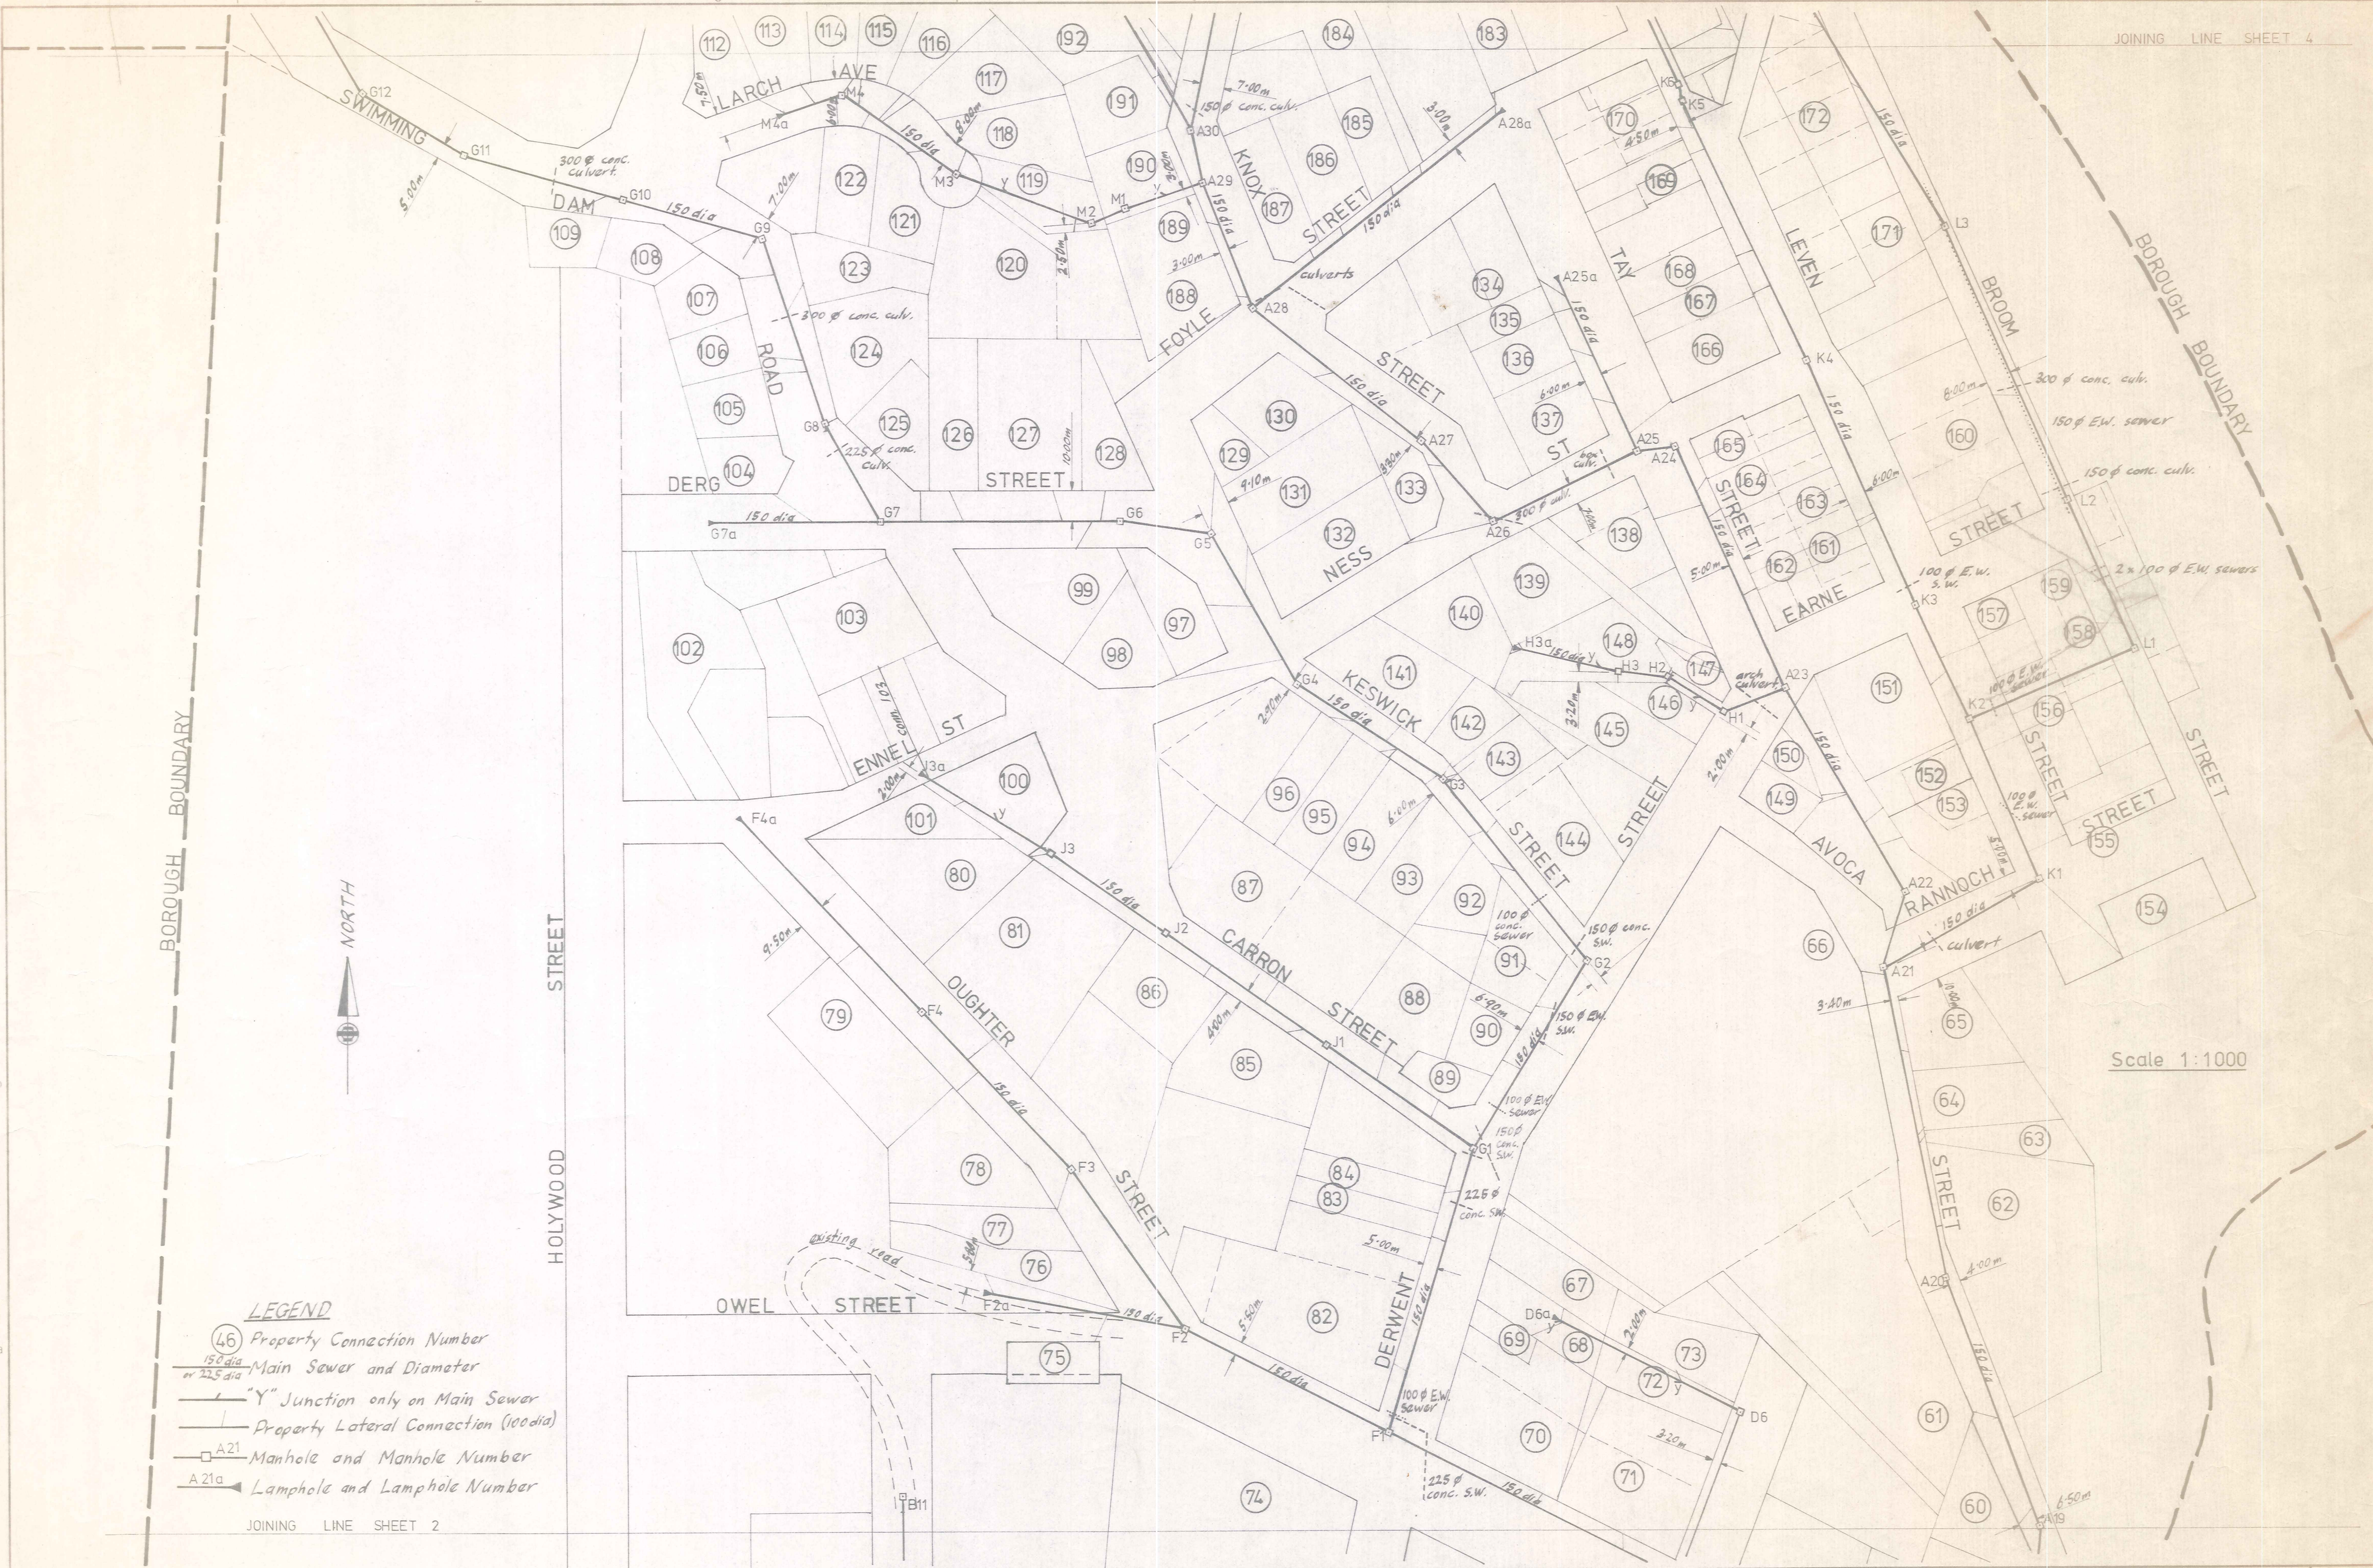

LEGEND

- (46) Property Connection Number
- 150 dia Main Sewer and Diameter
- or 22.5 dia
- "Y" Junction only on Main Sewer
- Property Lateral Connection (100dia)
- A21 Manhole and Manhole Number
- ◻ A21a Lamphole and Lamphole Number

JOINING LINE SHEET 2

Scale 1:1000

DUFFILL WATTS & KING LTD
 CONSULTING CIVIL & STRUCTURAL ENGINEERS
 Dundee, P.O. Box 5299 Ph. 77-133 Invercargill P.O. Box 576 Ph. 83049
 Balloch, P.O. Box 220 Phone 1425

NASEBY BOROUGH COUNCIL

AS BUILT SERVICES - SEWERAGE


DATUM
Sewerage
ORIGIN
Assumed

AMENDMENTS		
NO.	BY	DATE

NAME	DATE
Surveyed D.C. Wilson	Feb. '78
Drawn B.T. Kinaston	June '78
Checked B.T. Kinaston	June '78
Approved	June '78

JOB NO.	Sheet No
8581	3
File 26/5/16	of 5 sheets
L.B. 374	F.B. -

Rubbish Dump

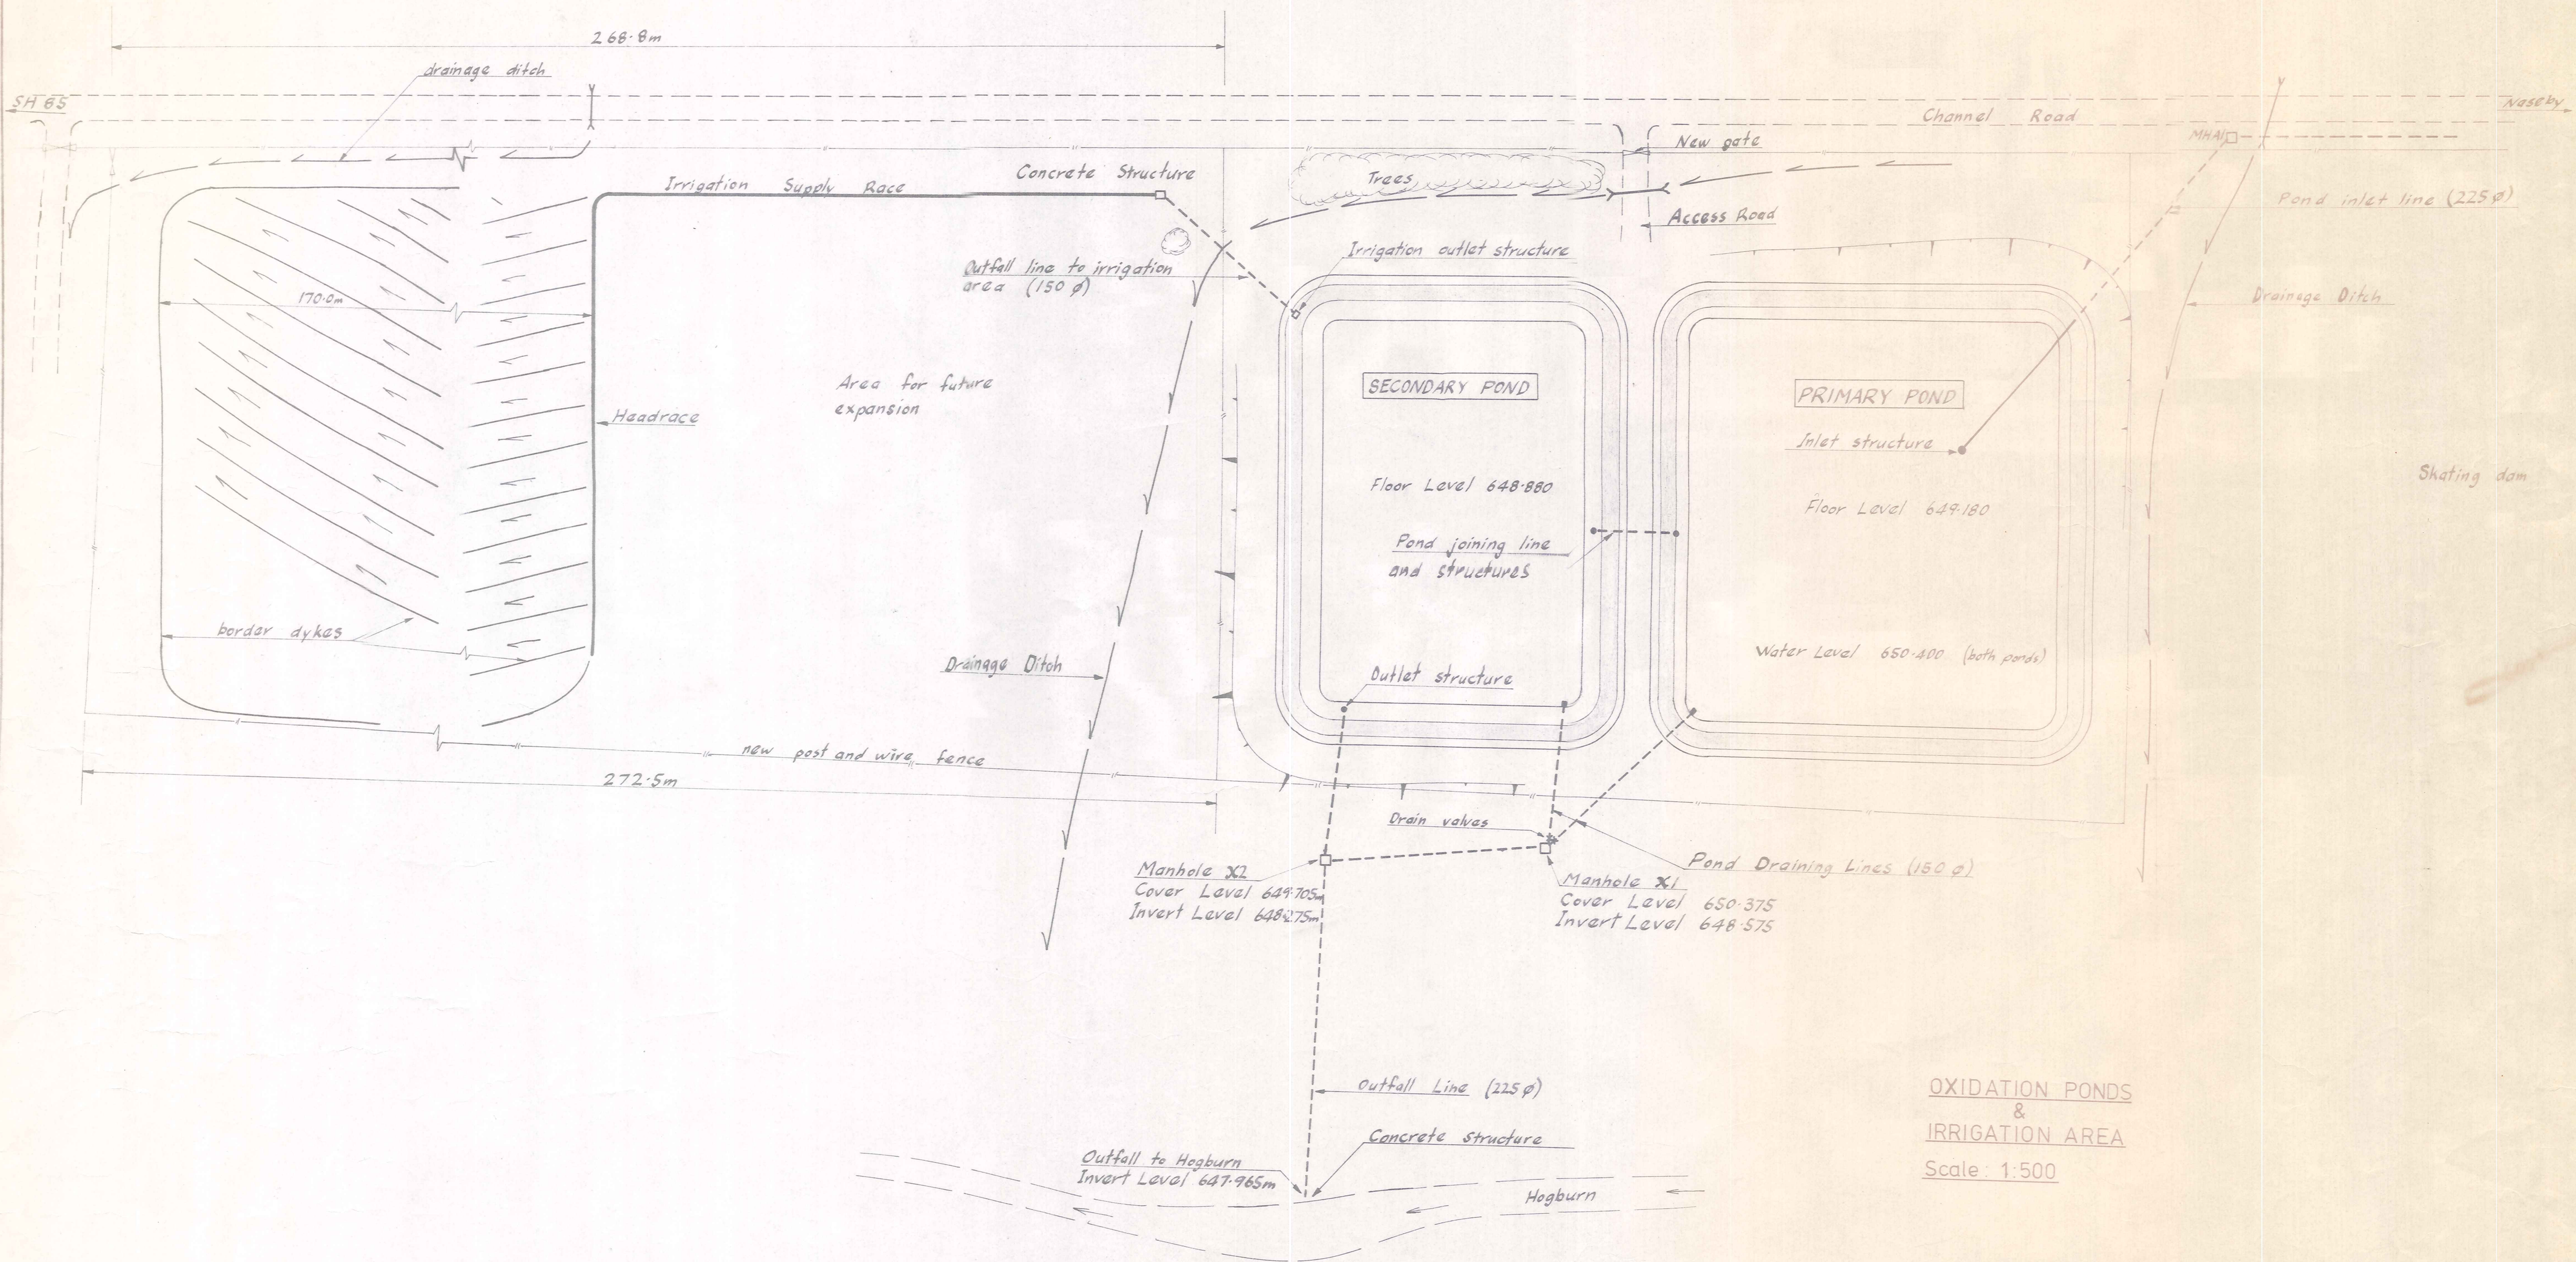

OXIDATION PONDS
&
IRRIGATION AREA
Scale: 1:500

DUFFILL WATTS & KING LTD
CONSULTING CIVIL & STRUCTURAL ENGINEERS
Dunedin: PO Box 5269 Ph 777-133 Invercargill: PO Box 576 Ph 83-049
Balclutha: PO Box 220 Ph 81-664 Cromwell: PO Box 82 Ph 50-391

NASEBY BOROUGH
COUNCIL

AS BUILT SERVICES - SEWAGE TREATMENT

DATUM
Sewerage
ORIGIN
Assumed

AMENDMENTS				NAME	DATE	JOB NO.	Sheet No
NO	BY	DATE	Appvd				
				Almasto	June '78	8581	5
				Almasto	Dec '78		
				Almasto	Dec '78		of 6 sheets
				Almasto	27-6-79		
				Almasto	June '79		

File 26/3/8 LB 37.8 F.B. -

