




MAY 1900


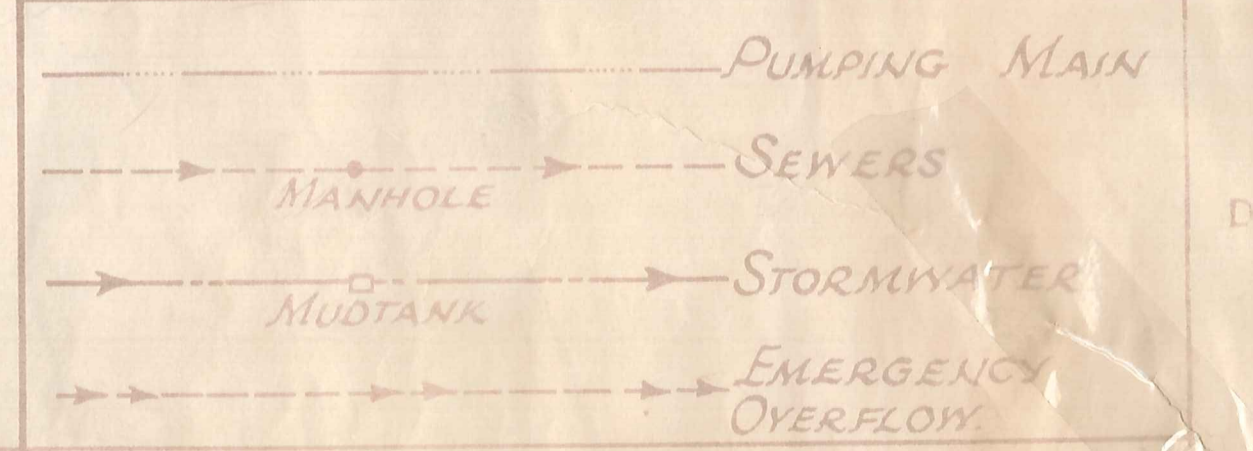


EXISTING SEWERS
 RECDRD PLAN
 DRG No. 3387/1


E. R. GARDEN & PARTNERS
 CONSULTING ENGINEERS
 DUNEDIN & INVERCARGILL

ROXBURGH BOROUGH COUNCIL
 Designed: Date: July 1900 Scale: 2 CHAINS TO 1 INCH
 1 : 1584
 Checked: Survey Ref:


| | |
|------------|-----------------------|
| AMENDMENTS | RELEVANT DRAWINGS ETC |
|------------|-----------------------|

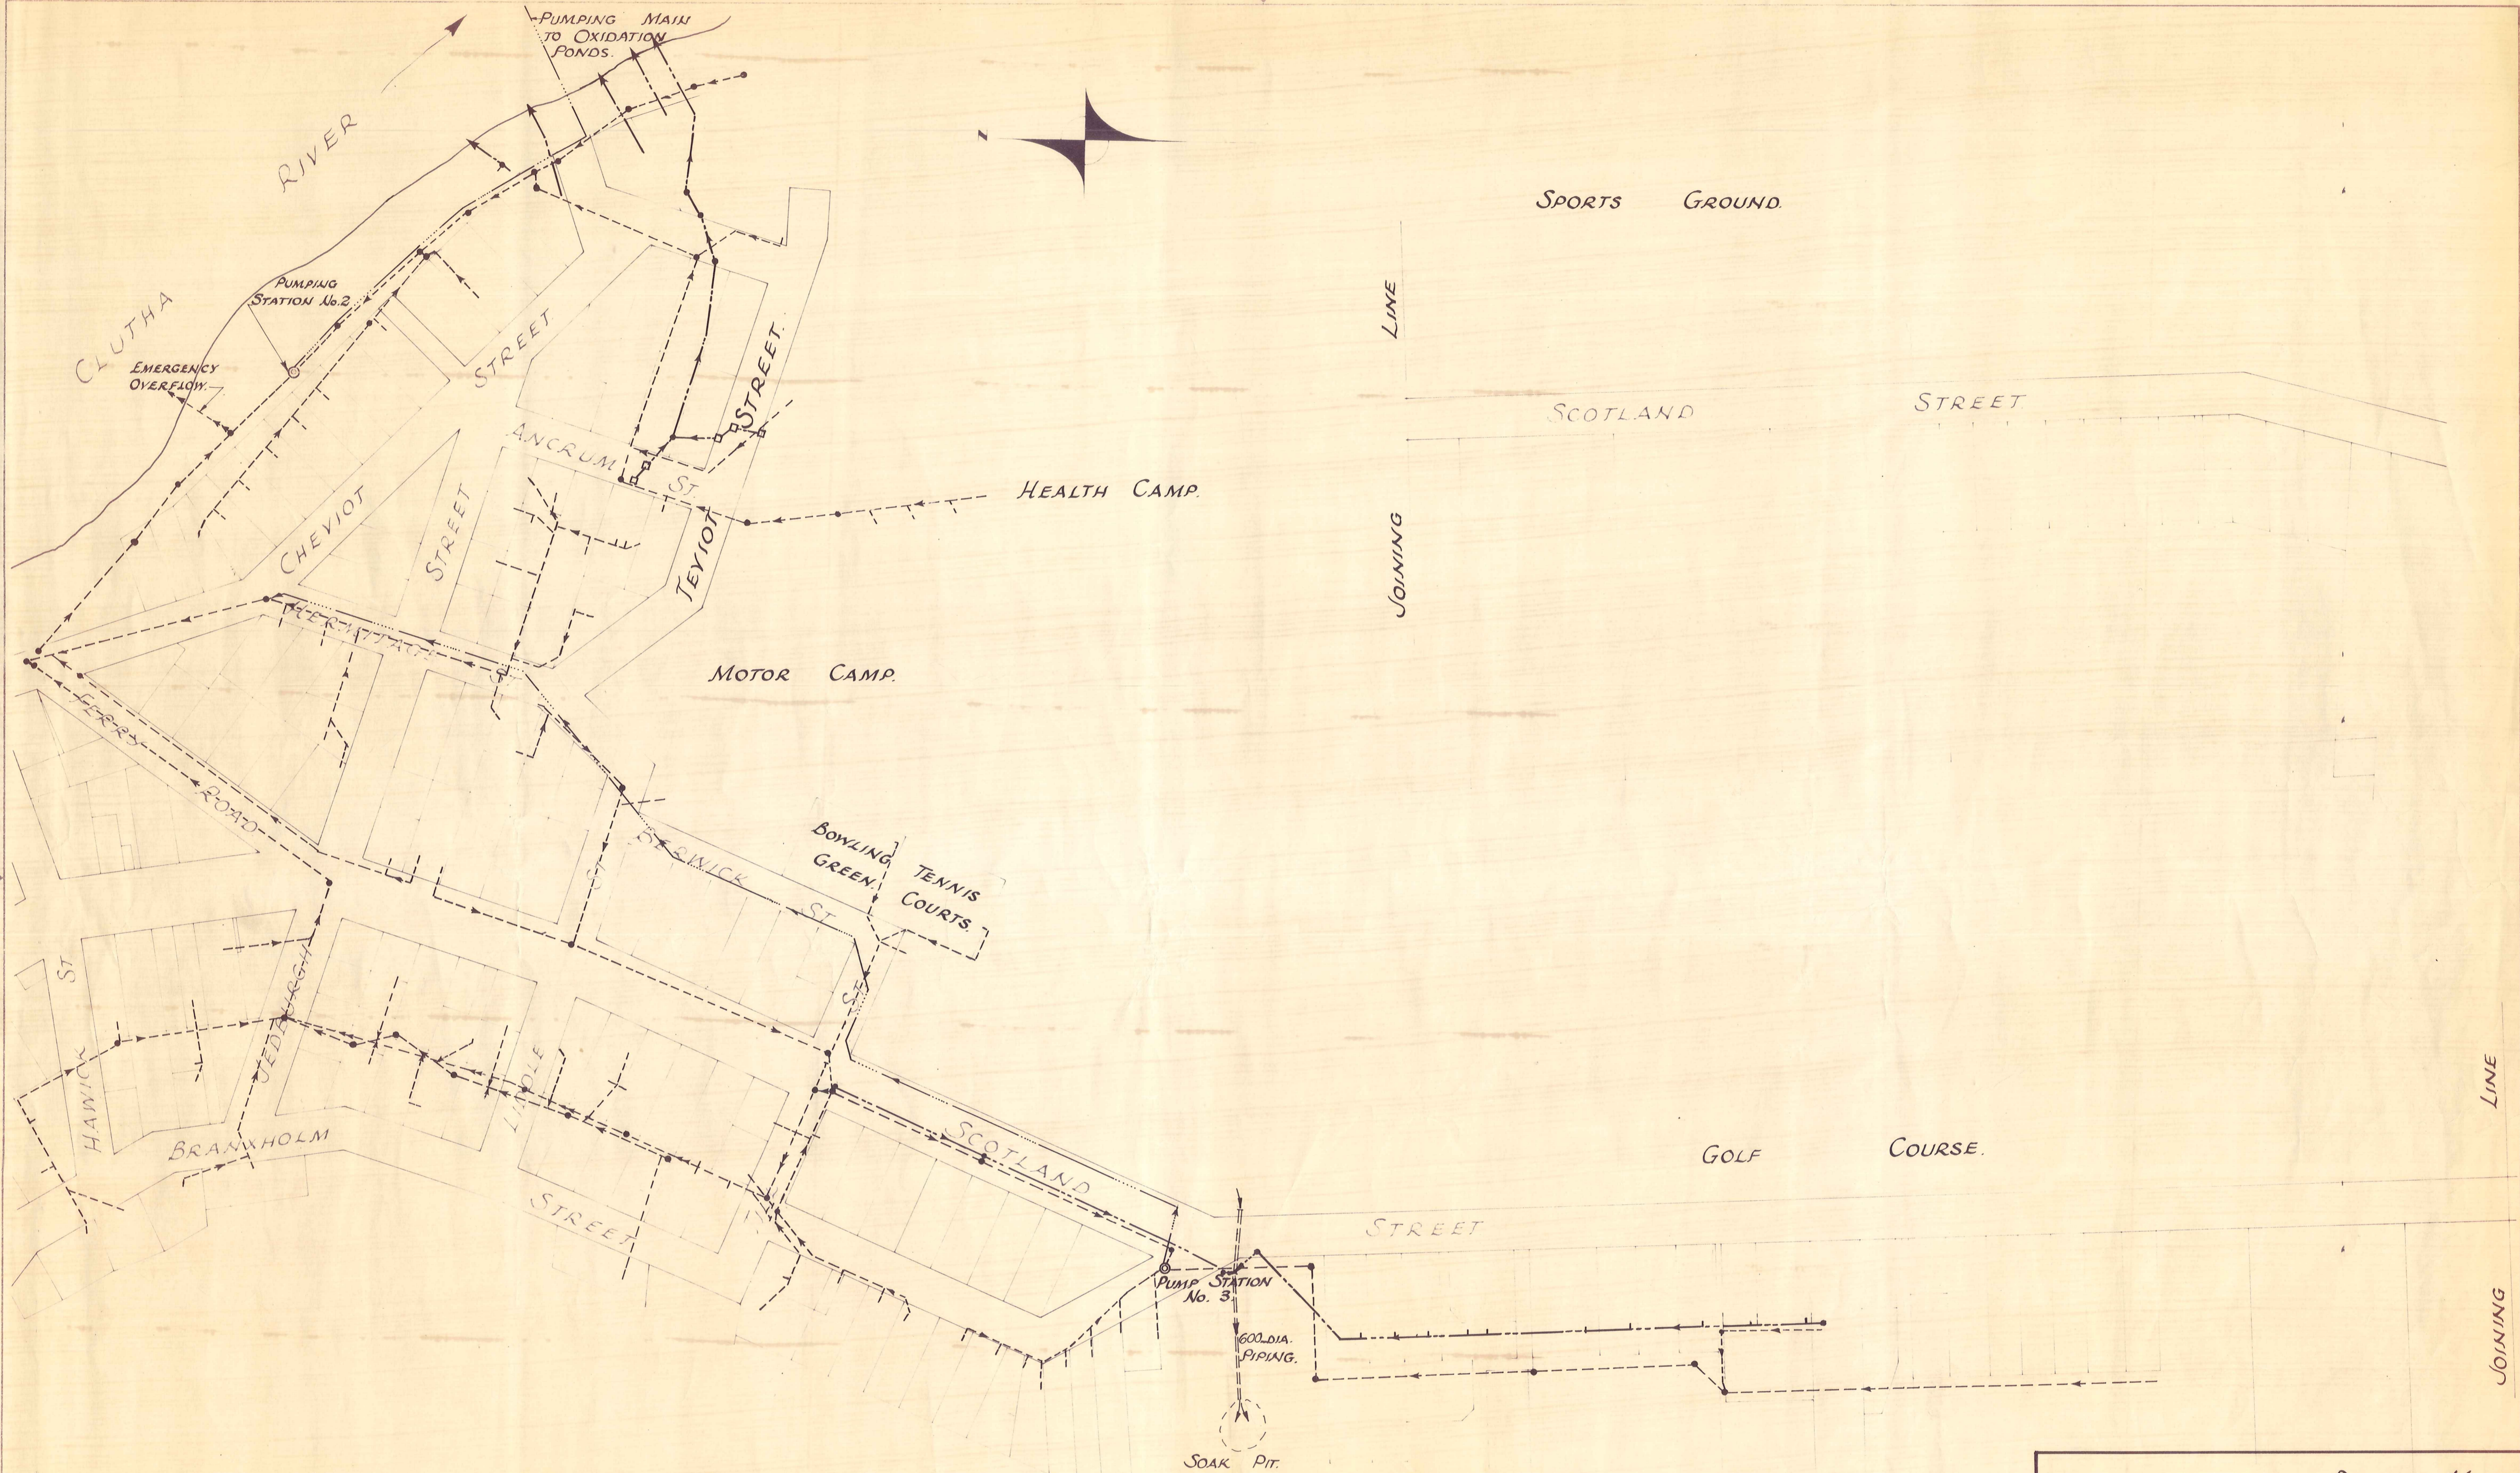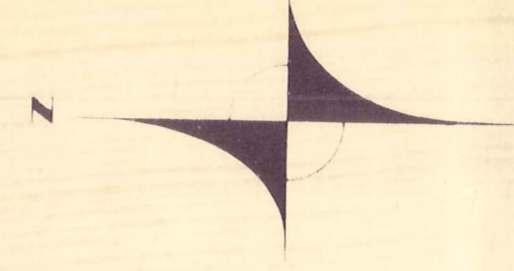



E. R. GARDEN & PARTNERS
CONSULTING ENGINEERS
DUNDEE &
NEWBROUGH



ROXBURGH BOROUGH COUNCIL
July 1980
3387
CHAINS TO LINCH
1 1584

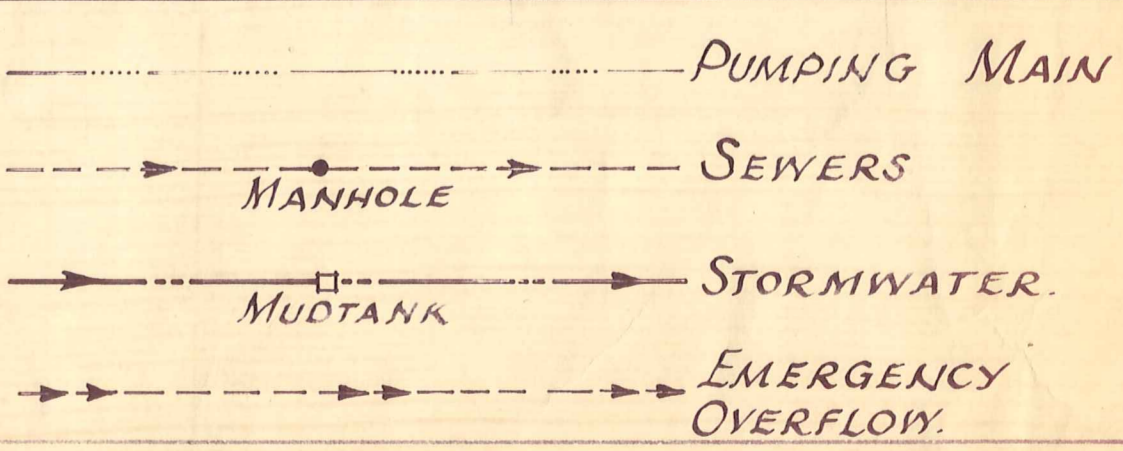

EXISTING SEWERS.
RECORD PLAN.
DRG No 3387/2

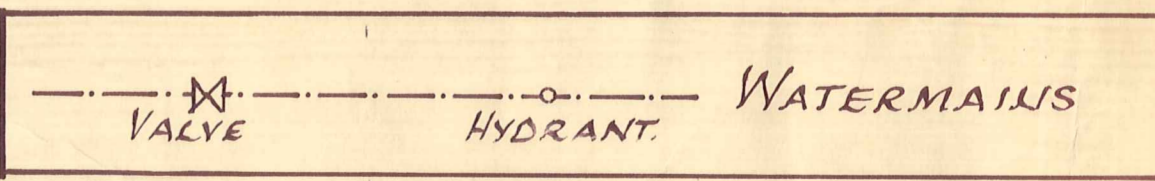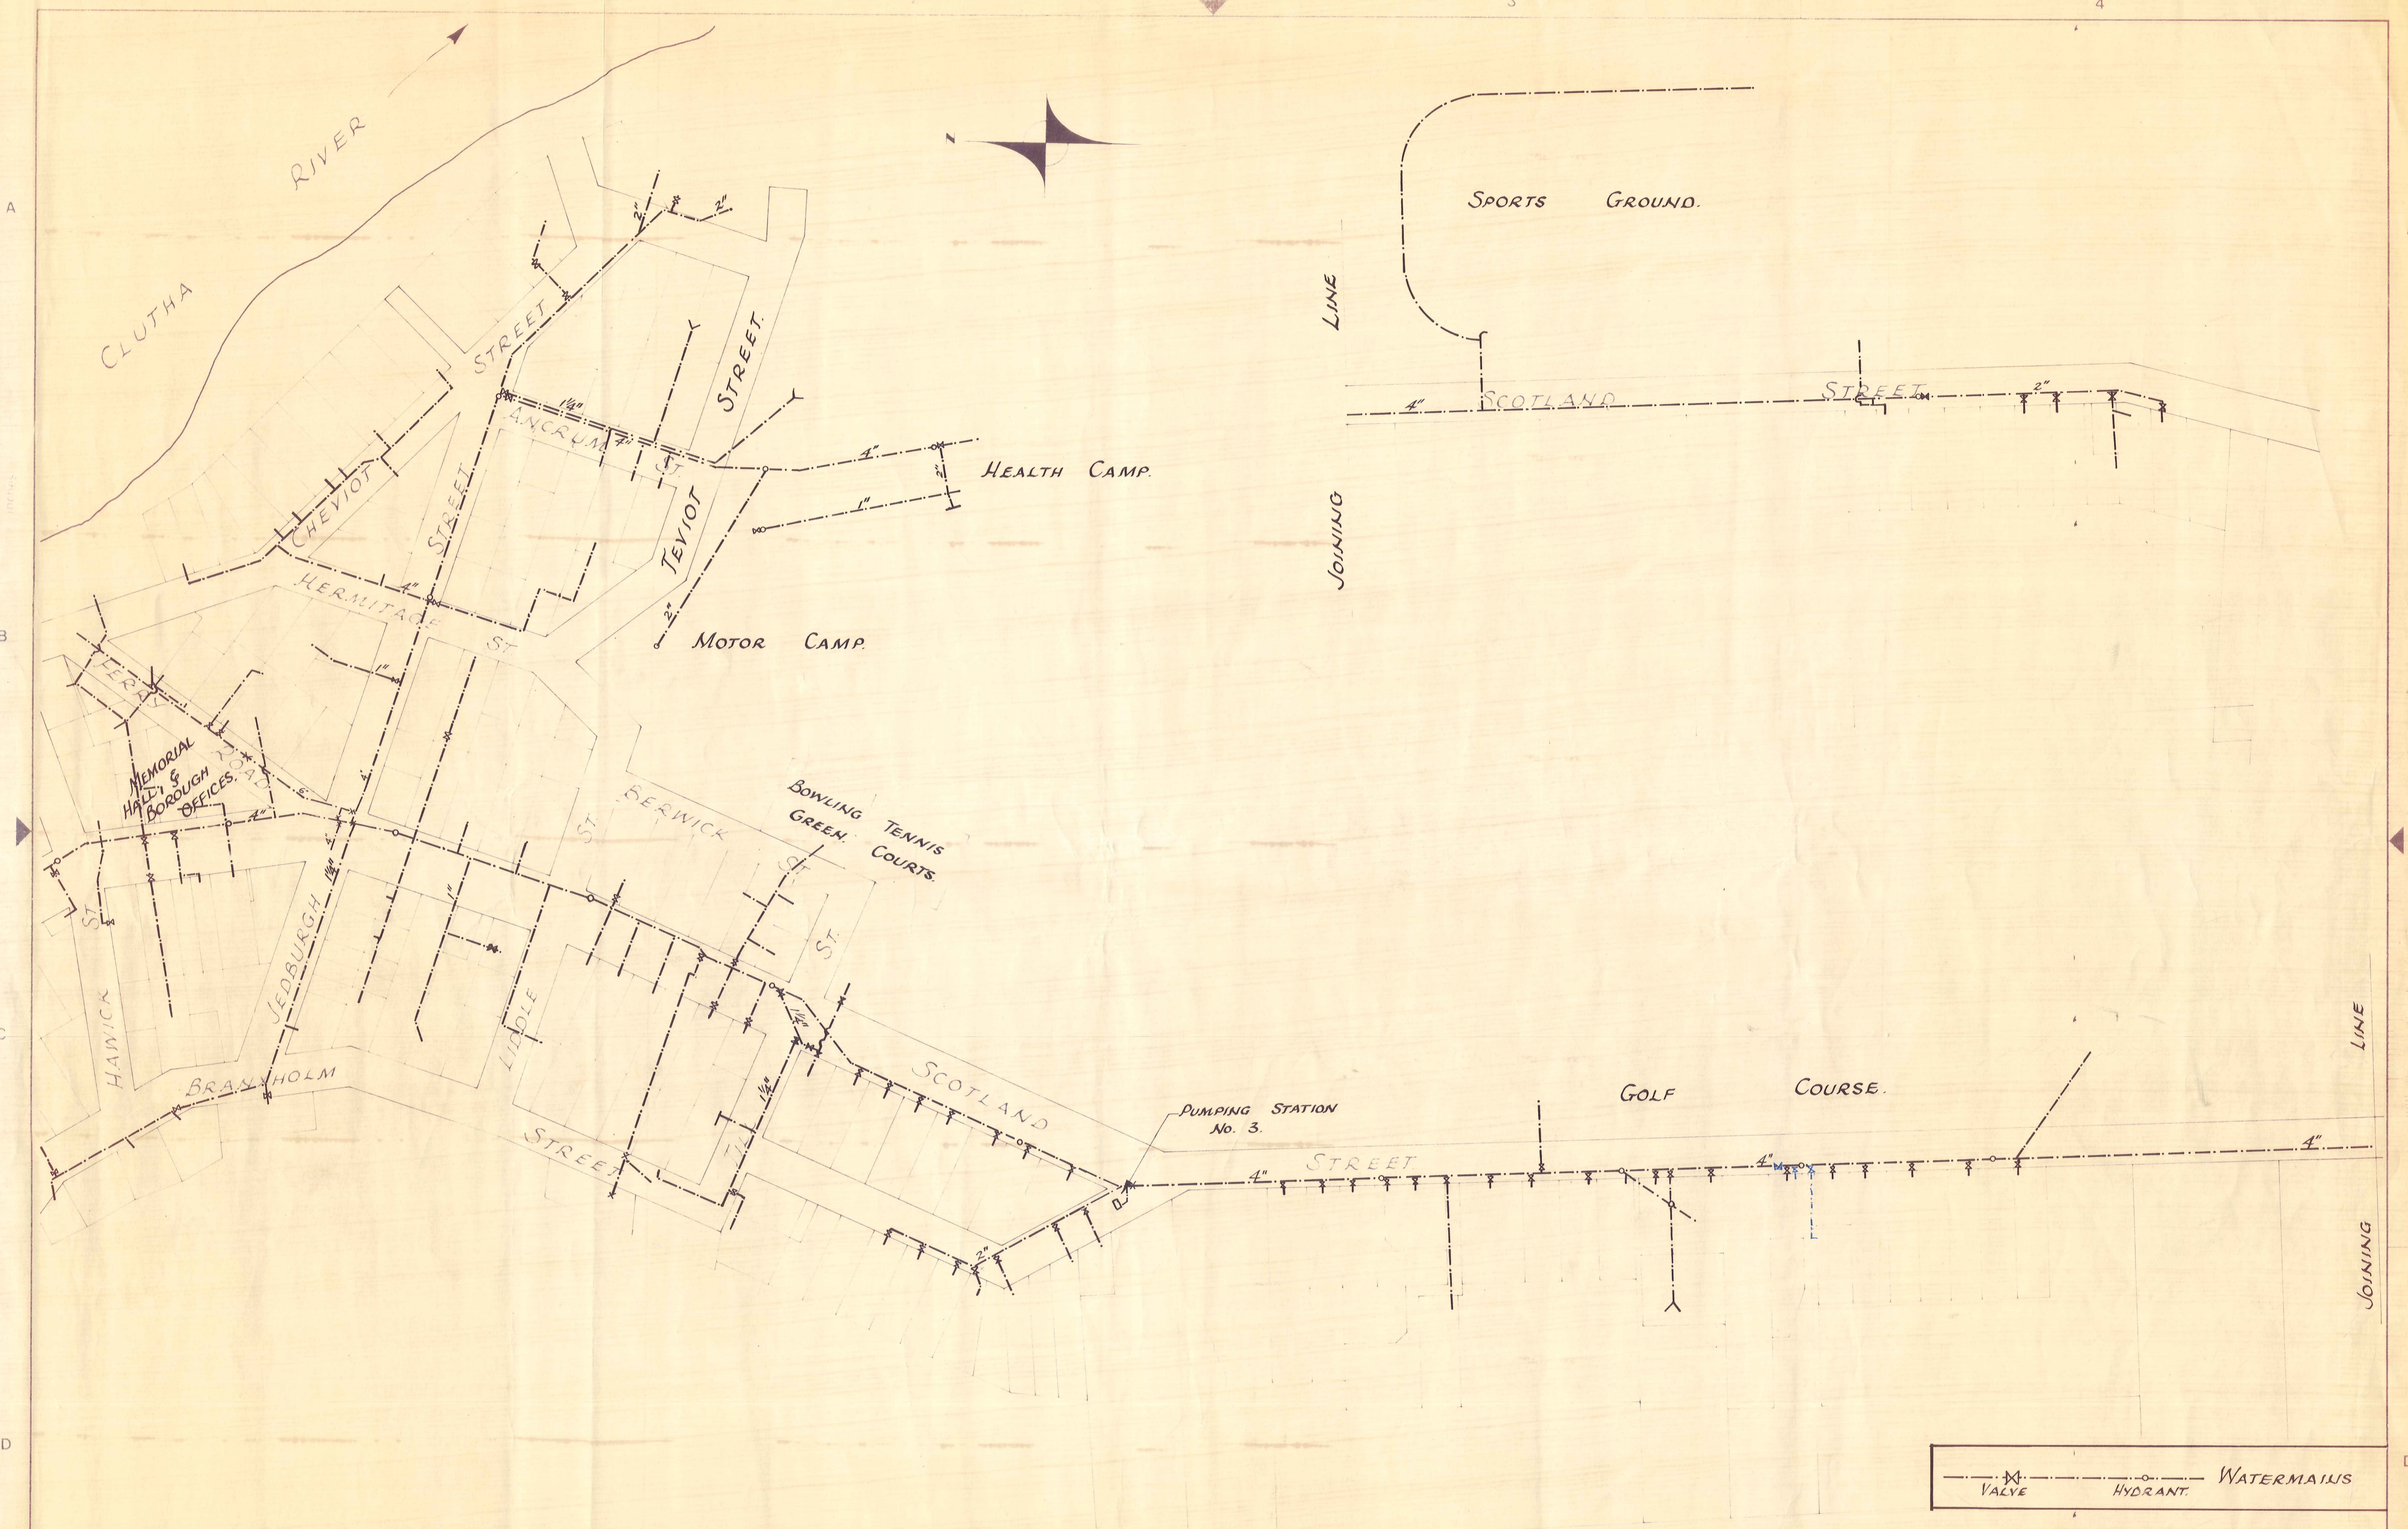

E. R. GARDEN & PARTNERS
CONSULTING ENGINEERS
DUNEDIN & INVERCARGILL



ROXBURGH BOROUGH COUNCIL EXISTING WATERMAINS RECORD PLAN
 Date: July 1980
 Scale: 2 CHAINS TO 1 INCH
 Plan No: 3387
 1 1584
 DRG No. 3387/4